

552 WEST 43RD STREET
NEW YORK, NEW YORK 10033

552 WEST 43RD STREET
5TH FLOOR
NEW YORK CITY 10013

212.965.0914
F: 212.965.0649

E: AKUSHNER@KUSHNERSTUDIOS.COM
W: WWW.KUSHNERSTUDIOS.COM

KUSHNER studios

KUSHNER STUDIOS
245 CANAL ST.
5TH FLOOR
NEW YORK CITY 10013

Client:
American Development Group
245 Canal Street
Fifth Floor
New York, New York
10013-4120
212.343.0347
F:212.343.0348

Expeditor:
Sally Love & Associates
144-21 22nd Drive
Flushing, New York 11367
(718) 544.8846
F:(718) 544.6276


Structural Engineer:
EYCO Construction International, Inc.
One Harmon Plaza
Secaucus, NJ 07094
(201) 574-0700
F:(201) 223.2475

Mechanical Engineer:

© Kushner Studios Architecture + Design, P.C.
2004
All Rights Reserved

These Drawings & The Ideas They Convey Are Instruments of Service For Kushner Studios Architecture + Design, P.C. & Remain Their Property. Neither This Drawing, Nor Any Ideas, Arrangements, Designs, Or Plans Therein, May Be Reproduced, Copied, Distributed, or Used in Any Manner Without the Written Consent of Kushner Studios Architecture + Design, P.C. To Search This File, Please Contact Kushner Studios Architecture + Design, P.C. All Rights Reserved. This File Not Limited To: Design & Architectural Fees, Legal Remedies Resulting From Pursuit Of Fees, Marketing & Patent Future Income, Etc.

DATE:	REV. #:	ISSUE	SPECIFICATIONS
04.05.04	1	As-Built	SPEC 1
			STRUCTURAL S1
			MECHANICAL M1
			ELECTRICAL E1
			SCHEDULES SC1
			ARCHITECTURALS A1

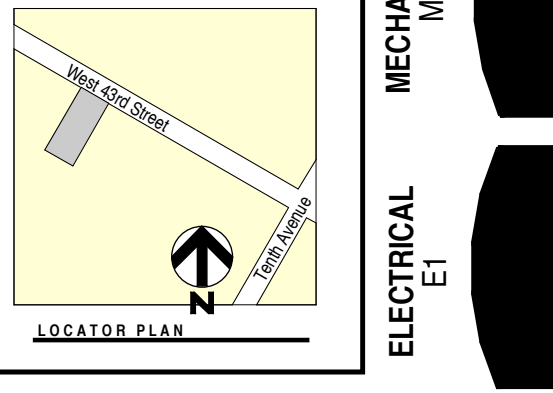

DOOR TYPES

COVER/SITE C1

SCALE: as noted
DATE: 04.05.04
DRAWN BY: ASV/RCS

SC1.20