

**Window Schedule - Interior**

#	Location	Style	W X H (Nominal)	Mat./Fin.	Manufacturer	Model Number	Type	Hardware	Details	Remarks
1-01	Entry	Fixed	1'-6" 5/8" x 8'-0"	Aluminum/Clear Anodized	EFCO or App. EQ	Custom	J	Cast Alum. Hardware By MFG		
1-02	Entry	Fixed	1'-6" 5/8" x 8'-0"	Aluminum/Clear Anodized	EFCO or App. EQ	Custom	J	Cast Alum. Hardware By MFG		
1-05	Office	Fixed	3'-0" x 7'-0"	Aluminum/Clear Anodized	EFCO or App. EQ	Custom	I	Cast Alum. Hardware By MFG		
1-06	Office	Fixed	3'-0" x 7'-0"	Aluminum/Clear Anodized	EFCO or App. EQ	Custom	I	Cast Alum. Hardware By MFG		
1-07	Entry	Transom	7'-0" x 1'-6"	Aluminum/Clear Anodized	EFCO or App. EQ	Custom	K	Cast Alum. Hardware By MFG		

**Window Schedule - Front Elevation**


#	Location	Style	W X H (Nominal)	Mat./Fin.	Manufacturer	Model Number	Type	Hardware	Details	Remarks
2A-05	Living Room	Awning/Fixed	5'-6" x 8'-0"	Aluminum/Clear Anodized	EFCO or App. EQ	Custom	A	Cast Alum. Hardware By MFG		
2A-06	Living Room	Fixed/Awning	2'-3" x 8'-0"	Aluminum/Clear Anodized	EFCO or App. EQ	Custom	B	Cast Alum. Hardware By MFG		
2A-07	M. Bedroom	Fixed/Awning	2'-3" x 8'-0"	Aluminum/Clear Anodized	EFCO or App. EQ	Custom	B	Cast Alum. Hardware By MFG		
2A-08	M. Bedroom	Awning/Fixed	5'-6" x 8'-0"	Aluminum/Clear Anodized	EFCO or App. EQ	Custom	A	Cast Alum. Hardware By MFG		
3A-05	Living Room	Awning/Fixed	5'-6" x 8'-0"	Aluminum/Clear Anodized	EFCO or App. EQ	Custom	A	Cast Alum. Hardware By MFG		
3A-06	Living Room	Fixed/Awning	2'-3" x 8'-0"	Aluminum/Clear Anodized	EFCO or App. EQ	Custom	B	Cast Alum. Hardware By MFG		
3A-07	M. Bedroom	Fixed/Awning	2'-3" x 8'-0"	Aluminum/Clear Anodized	EFCO or App. EQ	Custom	B	Cast Alum. Hardware By MFG		
3A-08	M. Bedroom	Awning/Fixed	5'-6" x 8'-0"	Aluminum/Clear Anodized	EFCO or App. EQ	Custom	A	Cast Alum. Hardware By MFG		
4A-05	Living Room	Awning/Fixed	5'-6" x 8'-0"	Aluminum/Clear Anodized	EFCO or App. EQ	Custom	A	Cast Alum. Hardware By MFG		
4A-06	Living Room	Fixed/Awning	2'-3" x 8'-0"	Aluminum/Clear Anodized	EFCO or App. EQ	Custom	B	Cast Alum. Hardware By MFG		
4A-07	M. Bedroom	Fixed/Awning	2'-3" x 8'-0"	Aluminum/Clear Anodized	EFCO or App. EQ	Custom	B	Cast Alum. Hardware By MFG		
4A-08	M. Bedroom	Awning/Fixed	5'-6" x 8'-0"	Aluminum/Clear Anodized	EFCO or App. EQ	Custom	A	Cast Alum. Hardware By MFG		
5A-05	Living Room	Awning/Fixed	5'-6" x 8'-0"	Aluminum/Clear Anodized	EFCO or App. EQ	Custom	A	Cast Alum. Hardware By MFG		
5A-06	Living Room	Fixed/Awning	2'-3" x 8'-0"	Aluminum/Clear Anodized	EFCO or App. EQ	Custom	B	Cast Alum. Hardware By MFG		
5A-07	M. Bedroom	Fixed/Awning	2'-3" x 8'-0"	Aluminum/Clear Anodized	EFCO or App. EQ	Custom	B	Cast Alum. Hardware By MFG		
5A-08	M. Bedroom	Awning/Fixed	5'-6" x 8'-0"	Aluminum/Clear Anodized	EFCO or App. EQ	Custom	A	Cast Alum. Hardware By MFG		
6A-04	Studio A	Casement/Fixed/Door	1'-9" x 6'-3" 1/2"	Aluminum/Clear Anodized	EFCO or App. EQ	Custom	H	Cast Alum. Hardware By MFG		
6A-05	Studio A	Casement/Fixed	7'-1" x 6'-3" 1/2"	Aluminum/Clear Anodized	EFCO or App. EQ	Custom	G	Cast Alum. Hardware By MFG		

**Window Schedule - Rear Elevation**

#	Location	Style	W X H (Nominal)	Mat./Fin.	Manufacturer	Model Number	Type	Hardware	Details	Remarks
2B-04	Living Room	Double Hung	3'-6" x 6'-0"	Aluminum/Clear Anodized	EFCO or App. EQ	Custom	C	Cast Alum. Hardware By MFG		
2B-05	Living Room	Double Hung	2'-6" x 6'-0"	Aluminum/Clear Anodized	EFCO or App. EQ	Custom	C	Cast Alum. Hardware By MFG		
2B-07	M. Bedroom	Double Hung	2'-6" x 6'-0"	Aluminum/Clear Anodized	EFCO or App. EQ	Custom	C	Cast Alum. Hardware By MFG		
2B-08	M. Bedroom	Double Hung	2'-6" x 6'-0"	Aluminum/Clear Anodized	EFCO or App. EQ	Custom	C	Cast Alum. Hardware By MFG		
3B-04	Living Room	Double Hung	3'-6" x 6'-0"	Aluminum/Clear Anodized	EFCO or App. EQ	Custom	C	Cast Alum. Hardware By MFG		
3B-05	Living Room	Double Hung	2'-6" x 6'-0"	Aluminum/Clear Anodized	EFCO or App. EQ	Custom	C	Cast Alum. Hardware By MFG		
3B-07	M. Bedroom	Double Hung	2'-6" x 6'-0"	Aluminum/Clear Anodized	EFCO or App. EQ	Custom	C	Cast Alum. Hardware By MFG		
3B-08	M. Bedroom	Double Hung	2'-6" x 6'-0"	Aluminum/Clear Anodized	EFCO or App. EQ	Custom	C	Cast Alum. Hardware By MFG		
5B-08	M. Bedroom	Double Hung	2'-6" x 6'-0"	Aluminum/Clear Anodized	EFCO or App. EQ	Custom	C	Cast Alum. Hardware By MFG		
6B-03	Studio B	Casement/Fixed	2'-7" x 6'-3" 1/2"	Aluminum/Clear Anodized	EFCO or App. EQ	Custom	F	Cast Alum. Hardware By MFG		
6B-04	Studio B	Casement/Fixed	7'-1" x 6'-3" 1/2"	Aluminum/Clear Anodized	EFCO or App. EQ	Custom	G	Cast Alum. Hardware By MFG		
6B-05	Bedroom	Casement/Fixed/Door	1'-9" x 6'-3" 1/2"	Aluminum/Clear Anodized	EFCO or App. EQ	Custom	H	Cast Alum. Hardware By MFG		

**Window Schedule - West Elevation**

#	Location	Style	W X H (Nominal)	Mat./Fin.	Manufacturer	Model Number	Type	Hardware	Details	Remarks
1-03	Exitg Storage	Awning	3'-6" x 6'-0"	Aluminum/Clear Anodized	EFCO or App. EQ	Custom	D	Cast Alum. Hardware By MFG		
1-04	Exitg Storage	Awning	3'-6" x 6'-0"	Aluminum/Clear Anodized	EFCO or App. EQ	Custom	D	Cast Alum. Hardware By MFG		
2A-01	Living Room	Awning	2'-6" x 3'-0"	Aluminum/Clear Anodized	EFCO or App. EQ	Custom	E	Cast Alum. Hardware By MFG		
2A-02	Living Room	Awning	2'-6" x 6'-0"	Aluminum/Clear Anodized	EFCO or App. EQ	Custom	D	Cast Alum. Hardware By MFG		
2A-03	Living Room	Awning	3'-6" x 6'-0"	Aluminum/Clear Anodized	EFCO or App. EQ	Custom	D	Cast Alum. Hardware By MFG		
2A-04	Living Room	Awning	3'-6" x 6'-0"	Aluminum/Clear Anodized	EFCO or App. EQ	Custom	D	Cast Alum. Hardware By MFG		
2B-01	Dining Area	Awning	2'-6" x 6'-0"	Aluminum/Clear Anodized	EFCO or App. EQ	Custom	D	Cast Alum. Hardware By MFG		
2B-02	Living Room	Awning	3'-6" x 6'-0"	Aluminum/Clear Anodized	EFCO or App. EQ	Custom	D	Cast Alum. Hardware By MFG		
2B-03	Living Room	Awning	3'-6" x 6'-0"	Aluminum/Clear Anodized	EFCO or App. EQ	Custom	D	Cast Alum. Hardware By MFG		
2B-06	M. Bedroom	Awning	2'-6" x 6'-0"	Aluminum/Clear Anodized	EFCO or App. EQ	Custom	D	Cast Alum. Hardware By MFG		
3A-01	Kitchen	Awning	2'-6" x 3'-0"	Aluminum/Clear Anodized	EFCO or App. EQ	Custom	E	Cast Alum. Hardware By MFG		
3A-02	Living Room	Awning	2'-6" x 6'-0"	Aluminum/Clear Anodized	EFCO or App. EQ	Custom	D	Cast Alum. Hardware By MFG		
3A-03	Living Room	Awning	3'-6" x 6'-0"	Aluminum/Clear Anodized	EFCO or App. EQ	Custom	D	Cast Alum. Hardware By MFG		
3A-04	Living Room	Awning	3'-6" x 6'-0"	Aluminum/Clear Anodized	EFCO or App. EQ	Custom	D	Cast Alum. Hardware By MFG		
3B-01	Dining Area	Awning	2'-6" x 6'-0"	Aluminum/Clear Anodized	EFCO or App. EQ	Custom	D	Cast Alum. Hardware By MFG		
3B-02	Living Room	Awning	3'-6" x 6'-0"	Aluminum/Clear Anodized	EFCO or App. EQ	Custom	D	Cast Alum. Hardware By MFG		
3B-03	Living Room	Awning	3'-6" x 6'-0"	Aluminum/Clear Anodized	EFCO or App. EQ	Custom	D	Cast Alum. Hardware By MFG		
3B-06	M. Bedroom	Awning	2'-6" x 6'-0"	Aluminum/Clear Anodized	EFCO or App. EQ	Custom	D	Cast Alum. Hardware By MFG		
4A-01	Kitchen	Awning	2'-6" x 3'-0"	Aluminum/Clear Anodized	EFCO or App. EQ	Custom	E	Cast Alum. Hardware By MFG		
4A-02	Living Room	Awning	2'-6" x 6'-0"	Aluminum/Clear Anodized	EFCO or App. EQ	Custom	D	Cast Alum. Hardware By MFG		
4A-03	Living Room	Awning	3'-6" x 6'-0"	Aluminum/Clear Anodized	EFCO or App. EQ	Custom	D	Cast Alum. Hardware By MFG		
4A-04	Living Room	Awning	3'-6" x 6'-0"	Aluminum/Clear Anodized	EFCO or App. EQ	Custom	D	Cast Alum. Hardware By MFG		
4B-01	Dining Area	Awning	2'-6" x 6'-0"	Aluminum/Clear Anodized	EFCO or App. EQ	Custom	D	Cast Alum. Hardware By MFG		
4B-02	Living Room	Awning	3'-6" x 6'-0"	Aluminum/Clear Anodized	EFCO or App. EQ	Custom	D	Cast Alum. Hardware By MFG		
4B-03	Living Room	Awning	3'-6" x 6'-0"	Aluminum/Clear Anodized	EFCO or App. EQ	Custom	D	Cast Alum. Hardware By MFG		
4B-06	M. Bedroom	Awning	2'-6" x 6'-0"	Aluminum/Clear Anodized	EFCO or App. EQ	Custom	D	Cast Alum. Hardware By MFG		
5A-01	Kitchen	Awning	2'-6" x 3'-0"	Aluminum/Clear Anodized	EFCO or App. EQ	Custom	E	Cast Alum. Hardware By MFG		
5A-02	Living Room	Awning	2'-6" x 6'-0"	Aluminum/Clear Anodized	EFCO or App. EQ	Custom	D	Cast Alum. Hardware By MFG		
5A-03	Living Room	Awning	3'-6" x 6'-0"	Aluminum/Clear Anodized	EFCO or App. EQ	Custom	D	Cast Alum. Hardware By MFG		
5A-04	Living Room	Awning	3'-6" x 6'-0"	Aluminum/Clear Anodized	EFCO or App. EQ	Custom	D	Cast Alum. Hardware By MFG		
5B-01	Dining Area	Awning	2'-6" x 6'-0"	Aluminum/Clear Anodized	EFCO or App. EQ	Custom	D	Cast Alum. Hardware By MFG		
5B-02	Living Room	Awning	3'-6" x 6'-0"	Aluminum/Clear Anodized	EFCO or App. EQ	Custom	D	Cast Alum. Hardware By MFG		
5B-03	Living Room	Awning	3'-6" x 6'-0"	Aluminum/Clear Anodized	EFCO or App. EQ	Custom	D	Cast Alum. Hardware By MFG		
5B-06	M. Bedroom	Awning	2'-6" x 6'-0"	Aluminum/Clear Anodized	EFCO or App. EQ	Custom	D	Cast Alum. Hardware By MFG		
6A-01	Studio A	Casement/Fixed	5'-0" x 6'-3" 1/2"	Aluminum/Clear Anodized	EFCO or App. EQ	Custom	G	Cast Alum. Hardware By MFG		
6A-02	Studio A	Casement/Fixed	5'-0" x 6'-3" 1/2"	Aluminum/Clear Anodized	EFCO or App. EQ	Custom	G	Cast Alum. Hardware By MFG		
6A-03	Studio A	Casement/Fixed	5'-0" x 6'-3" 1/2"	Aluminum/Clear Anodized	EFCO or App. EQ	Custom	G	Cast Alum. Hardware By MFG		
6B-01	Studio B	Casement/Fixed	5'-0" x 6'-3" 1/2"	Aluminum/Clear Anodized	EFCO or App. EQ	Custom	G	Cast Alum. Hardware By MFG		
6B-02	Studio B	Casement/Fixed	5'-0" x 6'-3" 1/2"	Aluminum/Clear Anodized	EFCO or App. EQ	Custom	G	Cast Alum. Hardware By MFG		

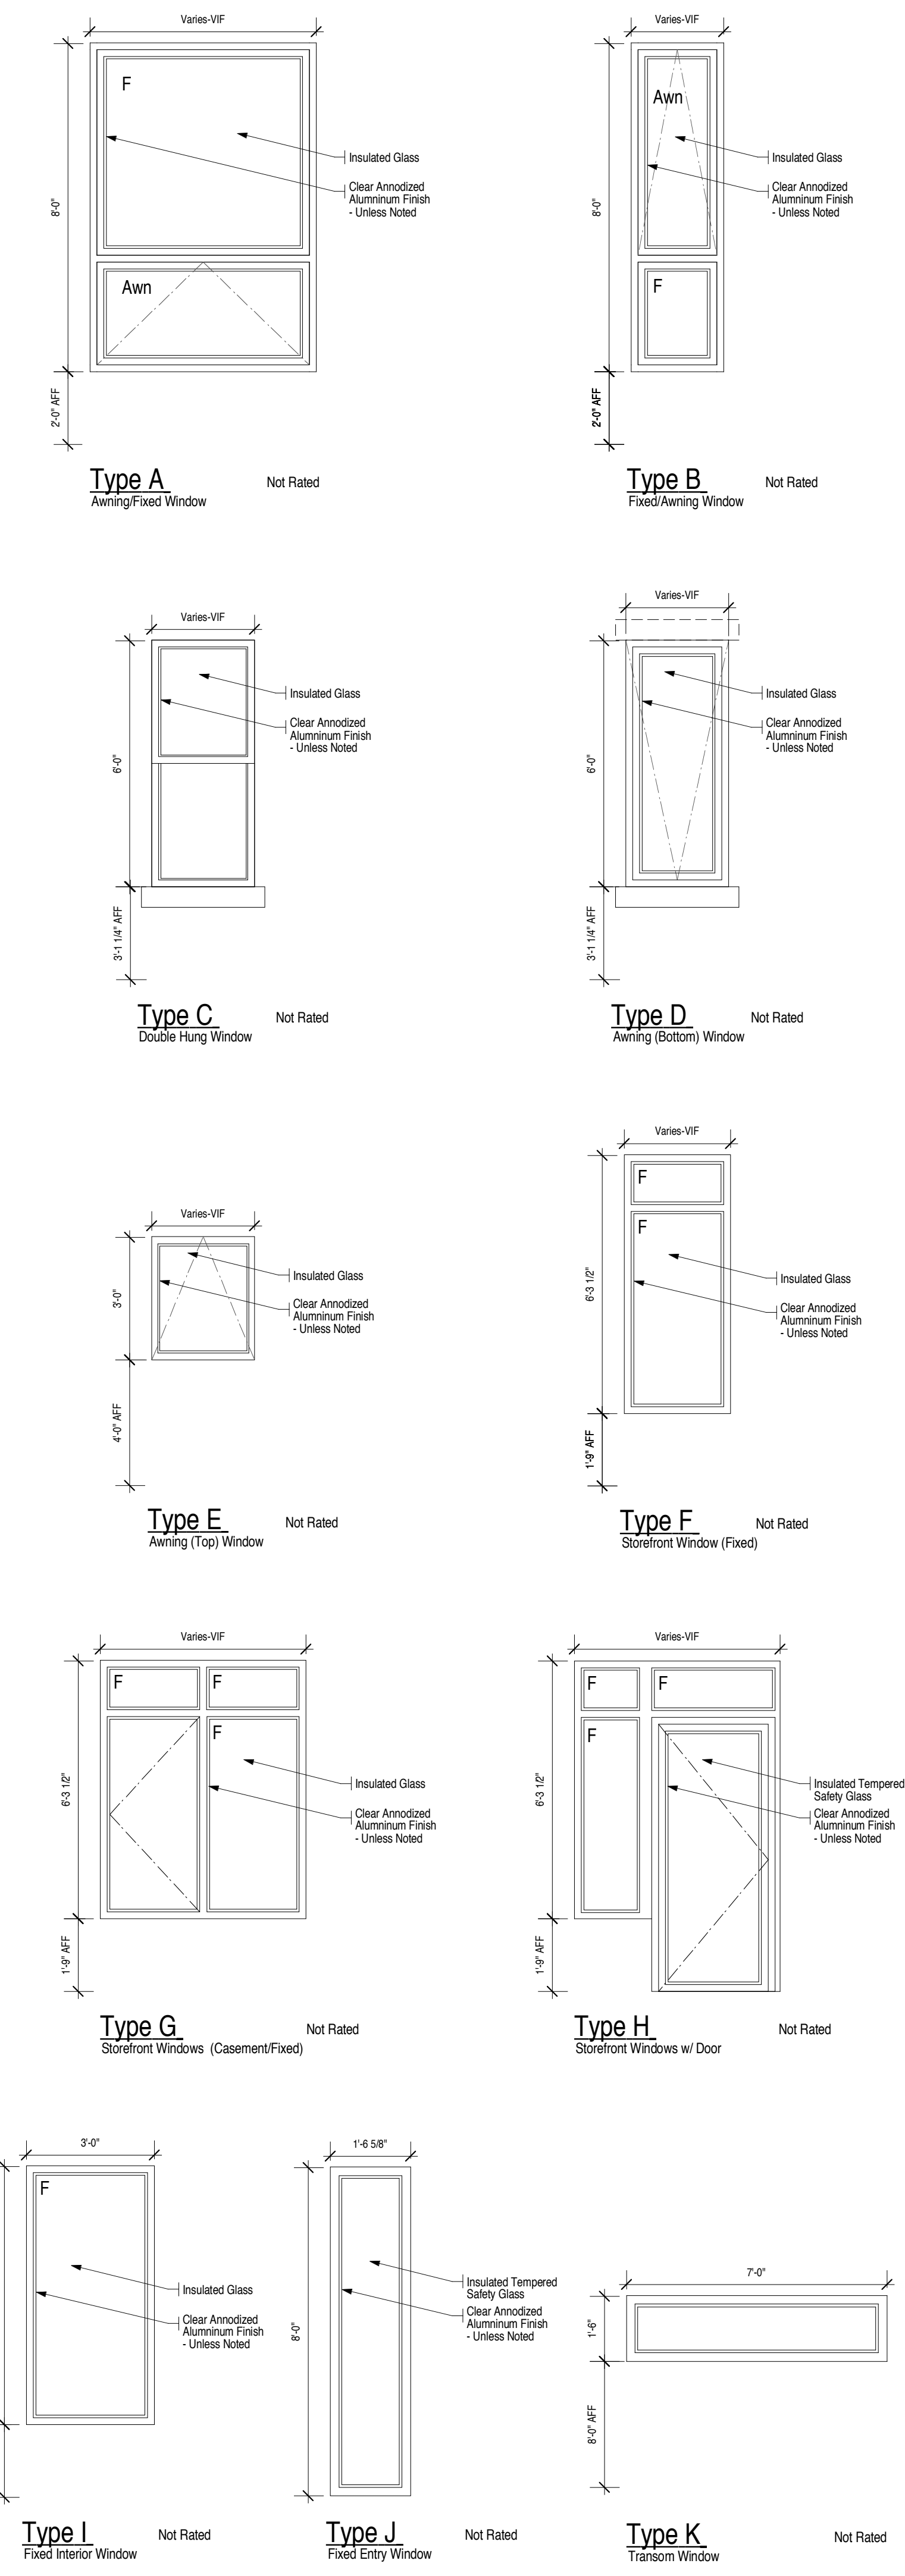

**552 WEST 43RD STREET**

552 WEST 43RD STREET  
NEW YORK, NEW YORK  
10033

KUSHNER studios

KUSHNER STUDIOS  
245 CANAL ST.  
5TH FLOOR  
NEW YORK CITY  
10013

E. AKUSHNER@KUSHNERSTUDIOS.COM  
W. WWW.KUSHNERSTUDIOS.COM

**Client:**  
American Development Group  
245 Canal Street  
Fifth Floor  
New York, New York  
10013-4120  
212.343.0347  
F:212.343.0348

**Expeditor:**  
Sally Love & Associates  
144-21 22nd Drive  
Flushing, New York 11367  
(718) 544.8846  
F:(718) 544.6276

**Structural Engineer:**  
EVCO Construction International, Inc.  
One Harmon Plaza  
Secaucus, NJ 07094  
(201) 974-0700  
F:(201) 223.2475

**Mechanical Engineer:**

© Kushner Studios Architecture + Design, P.C.  
2004  
All Rights Reserved

These Drawings & the Ideas They Convey Are Instruments of Service For Kushner Studios Architecture + Design, P.C. & Retain Their Property. Neither This Drawing, Nor Any Ideas, Annotations, Design, or Plans That They Contain Shall Be Approved By, Or Released, Reproduced, or Used in Any Manner Without the Written Consent of Kushner Studios Architecture + Design, P.C. To Release This Will Be Subject to a Separately Negotiated License Agreement. All Rights Reserved. Kushner Studios Architecture + Design, P.C. & Retain Their Property. Neither This Drawing, Nor Any Ideas, Annotations, Design, or Plans That They Contain Shall Be Approved By, Or Released, Reproduced, or Used in Any Manner Without the Written Consent of Kushner Studios Architecture + Design, P.C. To Release This Will Be Subject to a Separately Negotiated License Agreement. All Rights Reserved. Kushner Studios Architecture + Design, P.C. & Retain Their Property. Neither This Drawing, Nor Any Ideas, Annotations, Design, or Plans That They Contain Shall Be Approved By, Or Released, Reproduced, or Used in Any Manner Without the Written Consent of Kushner Studios Architecture + Design, P.C. To Release This Will Be Subject to a Separately Negotiated License Agreement. All Rights Reserved.

DATE	REV.#	ISSUE	STRUCTURAL	MECHANICAL	ELECTRICAL	SCHEDULES
04.05.04	1	As-built	S1	M1	E1	SC1

10903  
SCALE: as noted  
DATE: 04.05.04  
DRAWN BY: ASV/RCS

WINDOW SCHEDULE/TYPES  
COVER/SITE ARCHITECTURALS  
C1

SC10 SC2.10